




1 지상14층 창호평면도  
SCALE A1 : 1/400  
A3 : 1/800

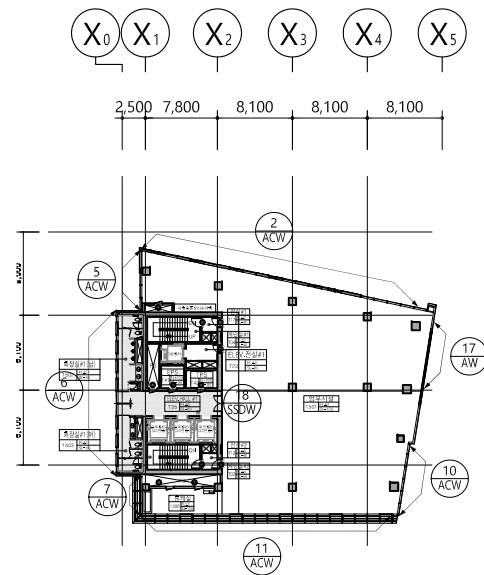


2 지상15층 창호평면도  
SCALE A1 : 1/400  
A3 : 1/800

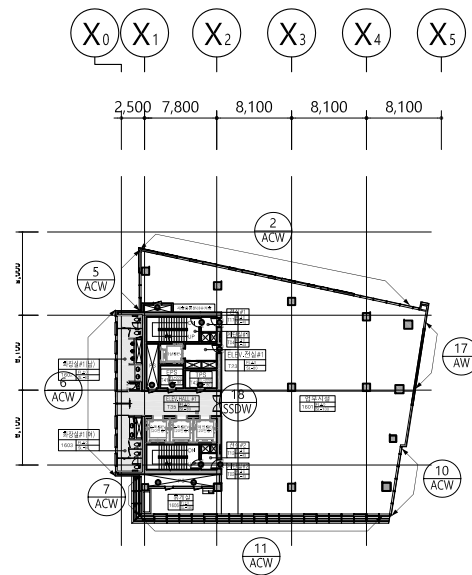


3 지상16층 창호평면도  
SCALE A1 : 1/400  
A3 : 1/800

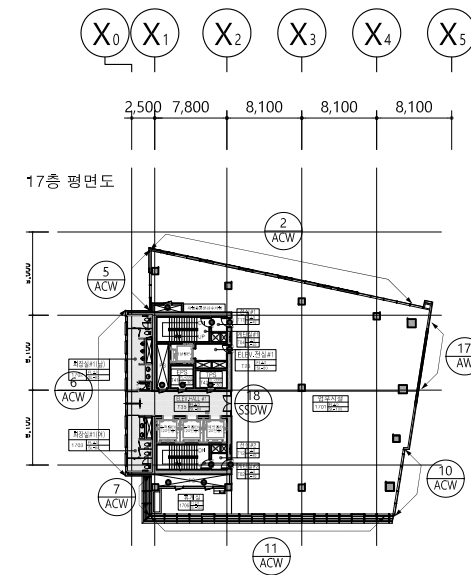


4 지상17층 창호평면도  
SCALE A1 : 1/400  
A3 : 1/800

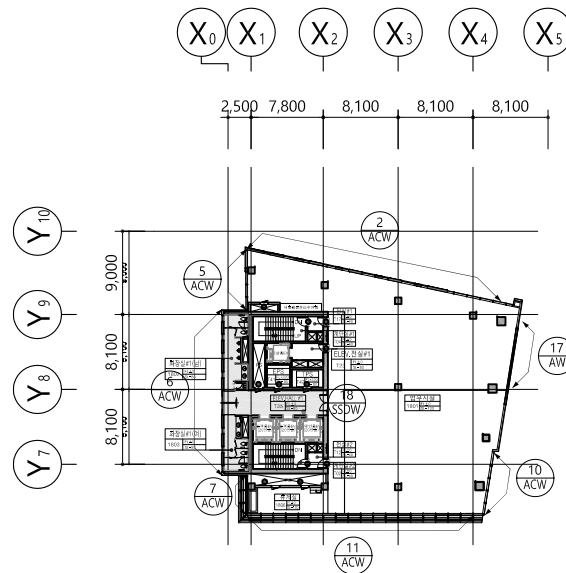


5 지상18층 창호평면도  
SCALE A1 : 1/400  
A3 : 1/800

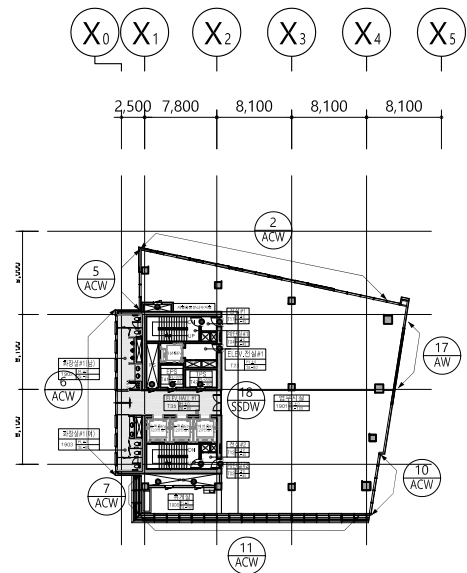


6 지상19층 창호평면도  
SCALE A1 : 1/400  
A3 : 1/800

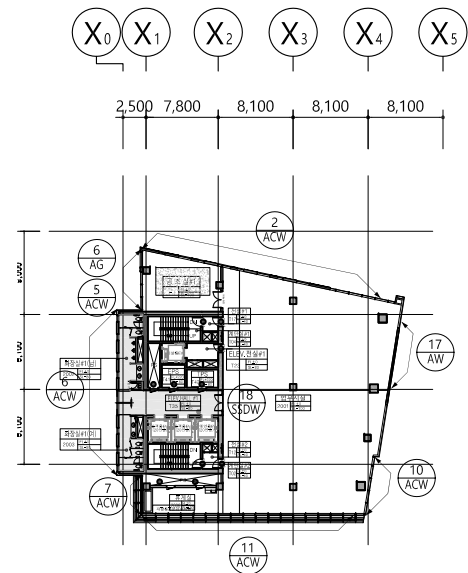

7 지상20층 창호평면도  
SCALE A1 : 1/400  
A3 : 1/800

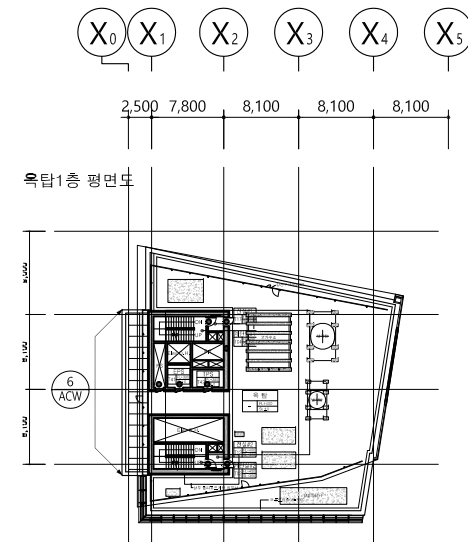

8 옥탑1층 창호평면도  
SCALE A1 : 1/400  
A3 : 1/800

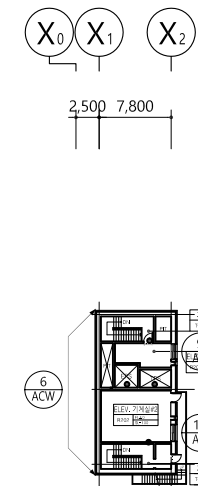

9 옥탑2층 창호평면도  
SCALE A1 : 1/400  
A3 : 1/800

프로젝트명  
PROJECT TITLE

디지털방송콘텐츠  
지원센터건립공사

대표기관

한국콘텐츠진흥원

협력기관

문화체육관광부  
Ministry of Culture, Sports and Tourism

미래창조과학부  
Ministry of Science, ICT & Future Planning

KCA 한국방송통신전파진흥원

시공사  
GENERAL CONTRACTOR

대우건설

경남기업

백산건설

설계사무소  
DESIGN OFFICE

Kor

경남기업건축사사무소

NOW

(주)나우동인건축사사무소

NOTE.

범례

감중방화문

방화열리메이커문

방화셔터

방범셔터, 제연커튼

2013.07

AS-BUILT

REV. DATE DESCRIPTION DRN. CHK. APP.

최종승인날짜  
APPROVAL DATE

2013.07

설계자

(주) 건원

확인자

CM

도면명  
DRAWING TITLE

창호평면도-5  
(지상14~옥탑층)

축척  
SCALE

A1(1/400), A3(1/800)

도면번호  
DRAWING NO.

A-0805